




**Kinslow, Keith & Todd, Inc.**  
 architecture/interiors/engineering  
 tel 918.744.4270  
 fax 918.744.7849  
 2200 south ufrica place, suite 200  
 tulsa, oklahoma 74114  
 www.kktarchitects.com

**MEDOW BROOK  
 SUITE 100 - 1500**

PROPERTY CLIENT  
 SERVICES

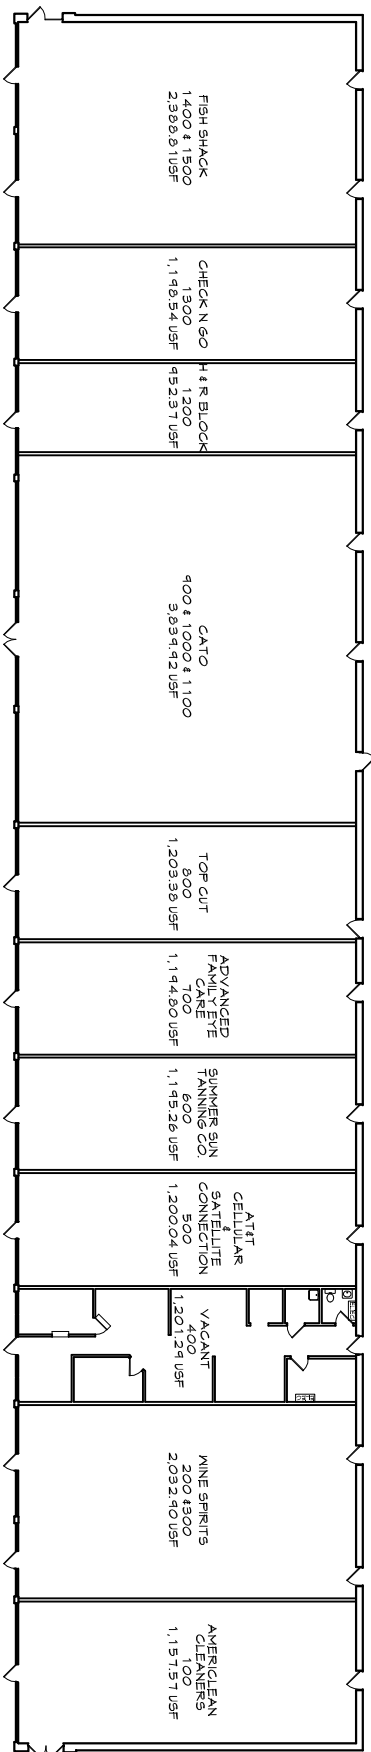

17,964.89 USF

**A FLOOR PLAN**

SCALE: N.T.S.



SCALE	N.T.S.
FILE NAME	MB-AS-1
MANAGER	ES.
DRAWN BY	TI.
5-26-09	

AS-BUILT  
 PLAN

**AS-1**